

**Heimdal, Monica**

---

**From:** John Brunini [jbrunini@brunini.com]  
**Sent:** Monday, November 18, 2013 5:35 PM  
**To:** Kato, Linda  
**Cc:** Heimdal, Monica; kb@geomap.tv; gmeyer@carlsonmccain.com  
**Subject:** Williston Village RV Park - Wetland Restoration Activities  
**Attachments:** Wetland restoration photos.zip; 21-Wetland As-built Plan.pdf

Ms. Kato,

In accordance with BIP 40, LLC's approved wetland restoration plan, attached please find "As-Built Plans" and several photographs of the restoration work recently completed on the referenced project. Review of the "As-Built Plans" shows that BIP 40 successfully removed fill material and restored the subject wetland area and adjacent slopes to their original elevations. This restoration work and review of all survey data was completed on or just prior to November 10, 2013. We had hoped to provide you with this report and its attachments on or before November 15, 2013. The delay in providing this to you is entirely my fault and not that of BIP 40, as its work was complete before the scheduled completion date.

In its approved Restoration Plan, BIP 40 indicated that it would conduct seeding of the restored wetland area (but not the adjacent slopes) upon completion of the restoration activities. Unfortunately, by the time restoration work was completed, existing weather conditions prevented the proposed seeding in the restored area. Carlson McCain has advised that existing ground temperatures are at or below 20 degrees Fahrenheit, and ground temperature would need to be at or above 50 degrees Fahrenheit in order for germination to occur. Accordingly, BIP 40 will address seeding issues for this restored wetland area during the Spring of 2014 or as soon as weather conditions allow for successful germination. As for the slopes adjacent to the restored areas, BIP 40's approved Restoration Plan does not contemplate seeding these areas until Spring, 2014. As you can see from the attached photos, BIP 40 has installed the proposed straw waddles and silt fences to minimize impacts associated with erosion/sedimentation.

Once you have had an opportunity to review this information, please contact me with any questions you may have. Once again, thank you very much for all of the work that you and Ms. Heimdal provided in expediting the approval of our Restoration Plan and AOC in this matter. Also, because the attachments to this email are fairly large in size, please confirm your receipt of this email.

Thanks,  
JB

**John A. Brunini**  
E: [jbrunini@brunini.com](mailto:jbrunini@brunini.com)  
P: 601-973-8712 F: 601-960-6902



**BRUNINI, GRANTHAM, GROWER & HEWES, PLLC**

The Pinnacle Building  
190 East Capitol St, Suite 100, Jackson, MS 39201  
Post Office Drawer 119, Jackson, MS 39205

[www.brunini.com](http://www.brunini.com)


Bio / V-Card

**Confidentiality Statement**

The information contained in this electronic message from the law firm of Brunini, Grantham, Grower & Hewes, PLLC is confidential or privileged. The information is intended to be for the use of the individual or entity named above. If you are not the intended recipient, be aware that any disclosure, copying, distribution or use of the contents of this message is prohibited. If you have received this electronic message in error, please notify us immediately by telephone at (601) 948-3101.

**IRS Circular 230 Notice**

To ensure compliance with requirements imposed by the IRS, we inform you that, unless specifically indicated otherwise, any tax advice contained in this communication (including any attachments) was not intended or written to be used, and cannot be used, for the purpose of (i) avoiding tax-related penalties under the Internal Revenue Code, or (ii) promoting, marketing, or recommending to another party any tax-related matter addressed herein.

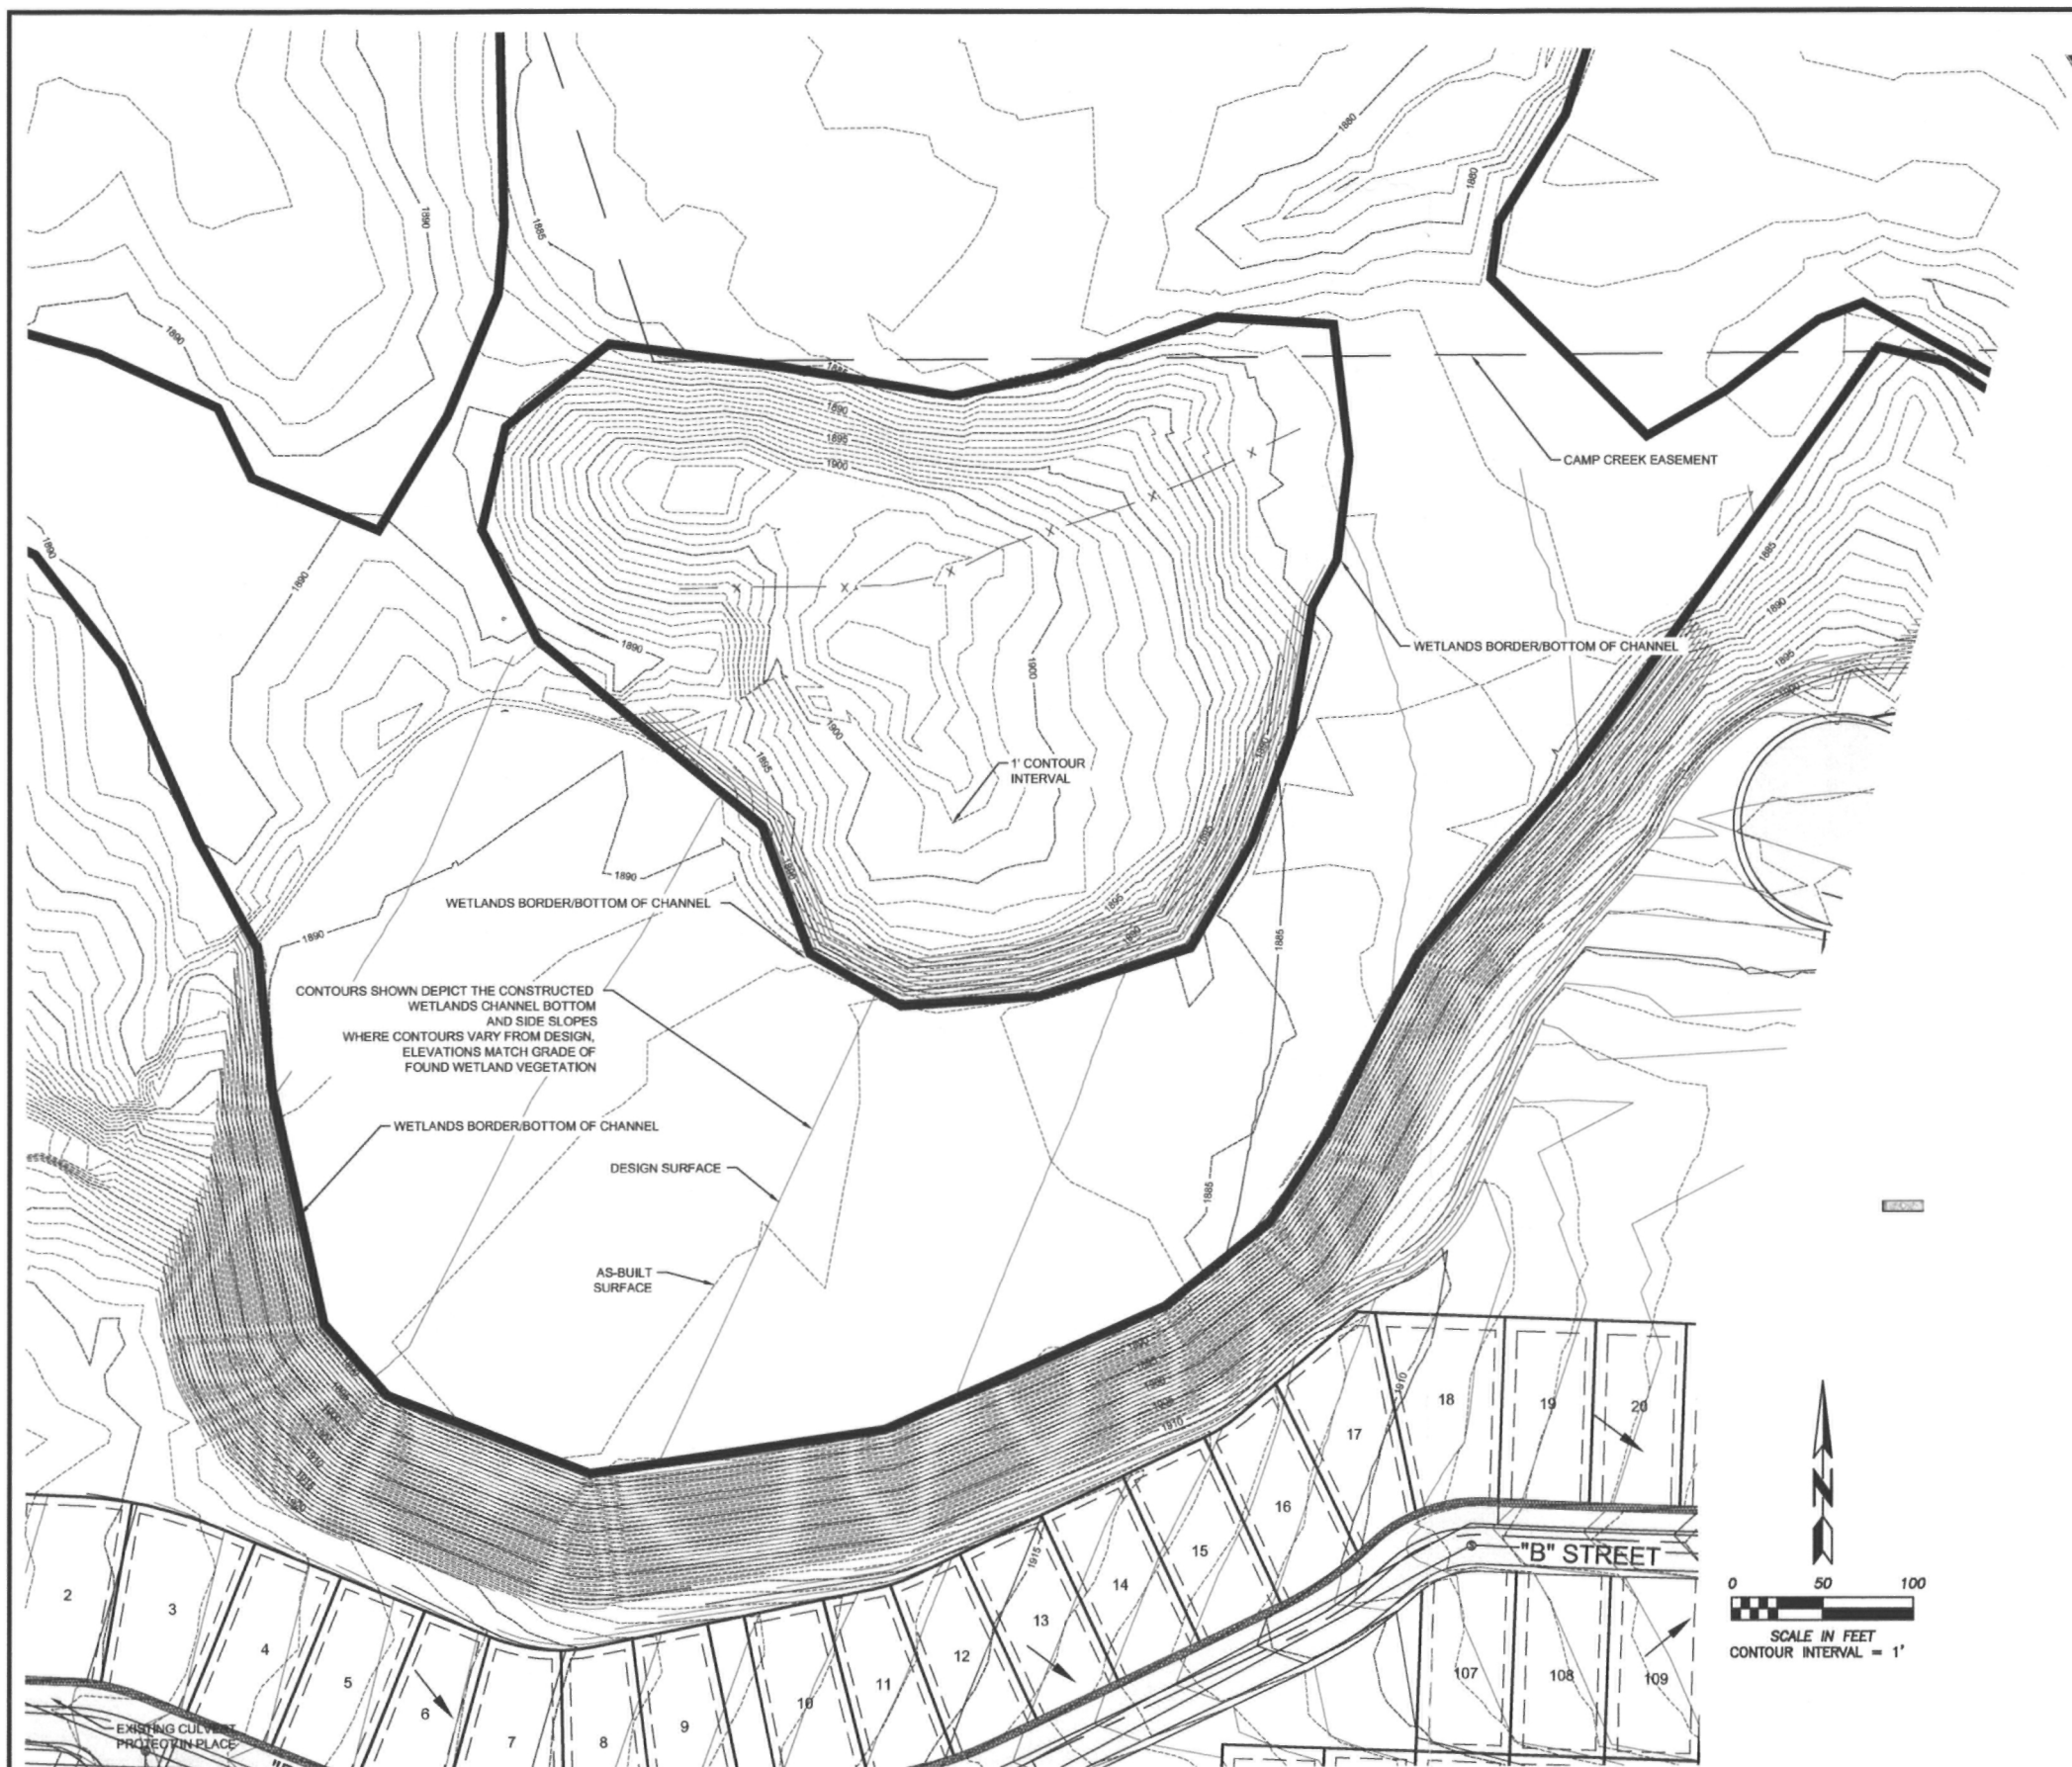

BY	DATE	REVISION DESCRIPTION

DESIGN PD PROJ. NO. 8188  
 DRAWN ML DATE 10/2013  
 CHECKED MV SURVEYED DJA.P.C.

**DJA.P.C.**  
 CONSULTING ENGINEERS & LAND SURVEYORS  
 3203 Russell Street, Missoula, Montana 59801-6991  
 Phone 406/721-4320 Fax 406/549-6371

**WILLISTON VILLAGE  
 MOBILE HOME PARK  
 WILLISTON, NORTH DAKOTA**

**AS-BUILT  
 WETLANDS GRADING  
 SURVEYED NOV. 6, 2013**

SHEET  
 OF  
**1 1**